



Metropolitan Sewerage District

OF BUNCOMBE COUNTY, NORTH CAROLINA

DUNSMORE AVENUE PHASE 1 SANITARY SEWER REHABILITATION

This notice is provided to inform you that the Metropolitan Sewerage District (MSD) will be replacing approximately 200 linear feet of the existing public sewer line along Dunsmore Avenue and the unnamed street near your residence and/or property. This work is necessary due to problems that have been experienced with the subject sewer line within the last few weeks.

The approximate location for the sewer project is noted in red on the attached map. Work on the sewer project is expected to begin on or near Monday, December 3, 2018. The work will include the replacement of the existing sewer main with new 8-inch pipe and re-connection of the existing service lines from adjacent structures to the new main.


The MSD construction crew performing this work will make the inconvenience to you as minimal as possible and will proceed with the work tasks in a timely manner. The anticipated work time is three (3) weeks depending on weather and other factors. After MSD's work is complete, all areas affected will be restored.

If you have any questions, please feel free to contact one of the following:

- R.L. Haynes (MSD System Services Construction Manager) at 828-284-7804
- Doug Dockery (MSD System Services Construction Crew Leader) at 828-337-9829

Thank you for your patience while we work to improve sewer service in your area.

~Protecting Our Natural Resources~

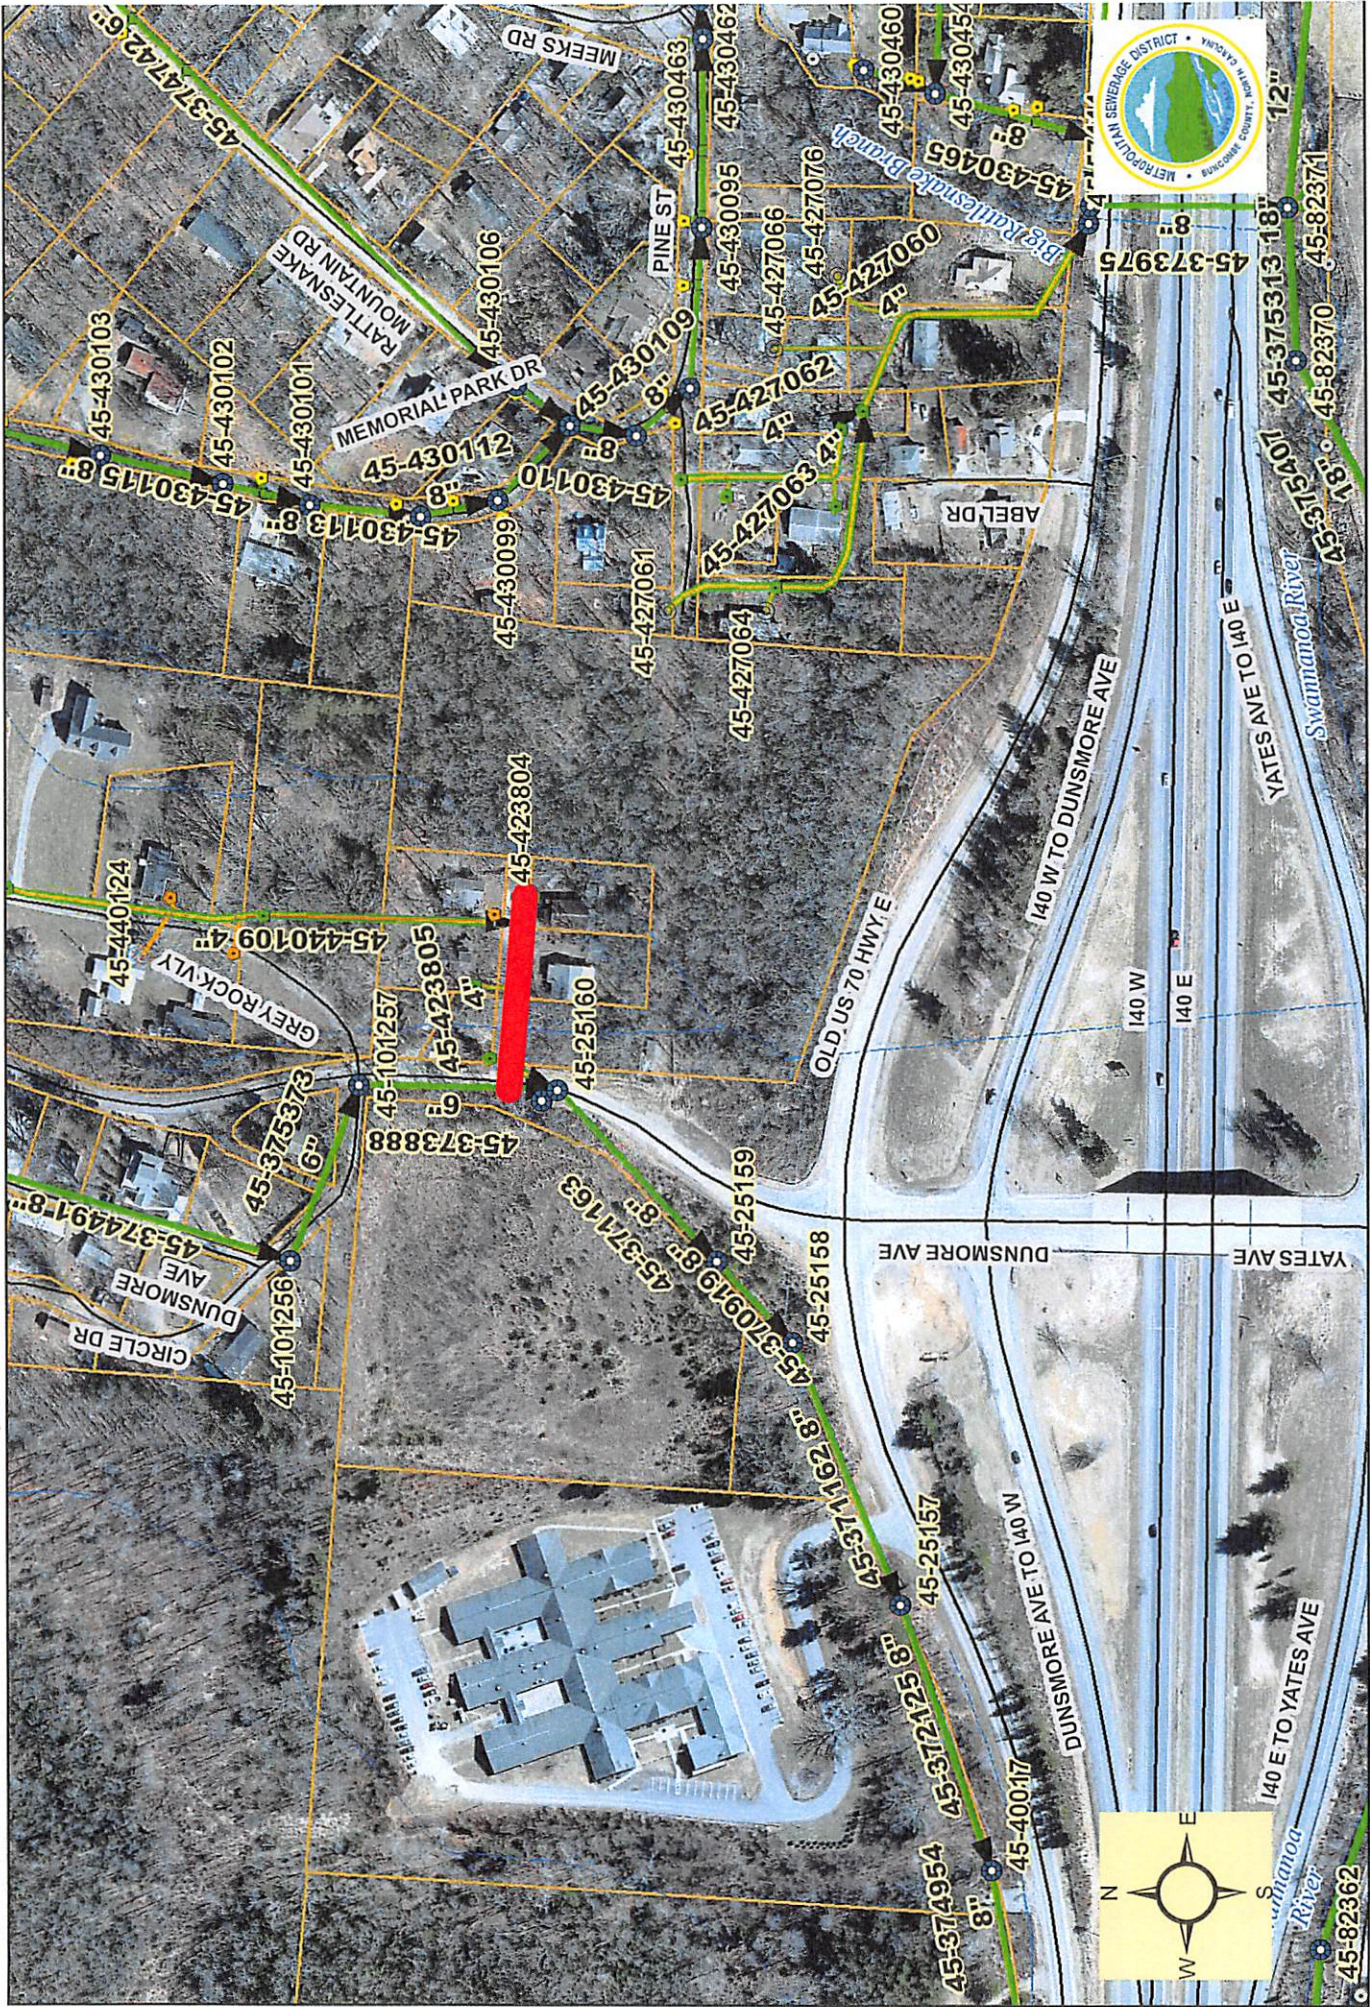

Dunsmore Avenue Phase I Sewer Rehabilitation
 Approx. Location Shown In Red - Map Not To Scale